

The following proffers are applicable:

- The property will be developed in substantial compliance with the Preliminary Master Plan. The maximum number of living units shall not exceed 666. This is approximately 60% of the number of units allowable by right under the present R2 zoning. The owner reserves the right to alter the plan in the following manner:
 - reduce the total number of units
 - increase the size of lots
 - reconfigure street and lot layout
 - adjust the mix of housing types to respond to marketing demands
 - adjust the amount of open space, however, a minimum of 50 acres of open space will be provided.
- The owner agrees not to increase the total number of condo or townhouse units.
- The public streets will be built to include curb and gutter on both sides of the road.
- The public street will be built to include a sidewalk along the road in Sections 8,9,10,11 & 20. Street lights will be provided along the public streets. The lights will be on poles not to exceed 20' in height and the light fixture will be shielded on the top so as not to emit light upwards. The light fixtures will be sodium vapor type which emits a softer yellow light rather than mercury vapor lights which emit an intense white light. The existing mercury vapor lights in Phase 1 Farmington will be replaced with sodium vapor lights shielded on the top consistent with those proposed in phase 2.
- The owner agrees to make improvements to Perrowville Road to include adding a dedicated left turn lane, a dedicated right turn lane, a dedicated through lane heading north and a dedicated through lane heading south. The construction will be coordinated with improvements to Perrowville Road being made as part of the Jefferson Forest High School renovations. The owner also agrees to install a traffic signal should it be deemed necessary by the traffic impact study.
- The owner agrees to install passive recreational facilities within the open space to include:
 - Walking trails along the streams as indicated on the Preliminary Master Plan.
 - Landscaping of the pocket parks (indicated as "PK") on the Preliminary Master Plan. The landscaping will vary from park to park and include benches, shrubs, flowering shrubs, trees, flowering trees, butterfly habitat, blueberry and raspberry bushes.
 - Picnic areas along the trail for use of neighborhood residents.
 - Graded area for volley ball courts for use of the neighborhood residents
 - Graded area for softball field for use of the neighborhood residents
- The owner agrees to install two roundabouts with a landscaped center island. The roundabouts will be constructed in a manner that will allow large trucks and emergency services vehicles to maneuver around the circle.
- The owner agrees to assist the Forest Volunteer Fire Department in their endeavor to build a new facility in the form of a cash contribution, pro bono design services for site design, pro bono services to market the existing facility, and pro bono services to grade the new site.


TOTALS:
FAF = 221
GRAYSTONE = 8
JEFFERSON BLUFFS = 64
CROSSINGS = 77
TOWNES = 62
ROCK CREEK = 14
STONEY RIDGE = 48
THE RETREAT = 19
SUB TOTAL = 513
SANDERS UNITS = 11
GRAND TOTAL = 524

- FARMINGTON AT FOREST MASTER POA
SEC 6 39 UNITS
SEC 7 34 UNITS
SEC 8 50 UNITS
SEC 9 34 UNITS
SEC 10 23 UNITS
SEC 20 41 UNITS
TOTAL = 221 UNITS
- GRAYSTONE - SEC 18 - 8 UNITS
- JEFFERSON BLUFFS - 64 UNITS SEC 18 -17 UNITS, SEC 19 - 33 UNITS, SEC 17 - 4 UNITS, SEC 20 - 14 UNITS = 64 TOTAL
- THE CROSSINGS - SEC 15 - 19 UNITS, SEC 16 - 33 UNITS, SEC 17 - 25 UNITS = 77 TOTAL
- THE TOWNES - SEC 13 = 62 UNITS
- ROCK CREEK - SEC 12 = 14 UNITS
- STONEY RIDGE - SEC 20 = 48 UNITS
- THE RETREAT - SEC 11 = 19 UNITS
- COMMON AREA

ARCHITECTURAL REVIEW COMMITTEE (FEBRUARY, 2023)
DOUG LEECH FAF POA
RHONDA KNIGHT FAF POA
DICK STERNE THE RETREAT POA
DARA FARRAR THE CROSSINGS POA
JILL RUFUS STONEY RIDGE CONDOS
KIM CHEATHAM JEFFERSON RIDGE POA
TO BE DETERMINED THE TOWNES POA

NOTES:

- NAME OF DEVELOPMENT: FARMINGTON AT FOREST-PHASE 2
- TAX MAP NUMBER(S): 99-A-27
- APPLICANT & OWNER: WEST CROSSINGS, LLC
3594 ELKTON FARM ROAD
FOREST, VA 24551
- AREA OF DEVELOPMENT: 189.6 ACRES
- CURRENT ZONING: PRD
- PROPOSED USE: MIXED USE RESIDENTIAL
- DENSITY: 3.4 UNITS PER ACRE
- LOT SIZE: SEE CHART
- WATER & SANITARY SEWER SERVICE: BCPSA
- SIGHT DISTANCE: PROPOSED ENTRANCE EXCEEDS 900' IN BOTH DIRECTIONS.
- ALL STREETS TO BE PUBLIC, EXCEPT WHEN NOTED AS PRIVATE
- SOURCE OF TITLE: WEST CROSSING, LLC
PARCEL 99-A-27 INST. #0060007541
- ZONING FOR ALL ADJOINING PROPERTIES IS R-2 ON NORTH, EAST & WEST SIDE AND R-1 ON SOUTH SIDE.
- THERE ARE NO KNOWN SITES OF HUMAN BURIAL ON THE PROPERTY.
- ALL PUBLIC RIGHT OF WAY WILL BE DEDICATED AND WILL BE APPROVED AND MAINTAINED BY VDOT.

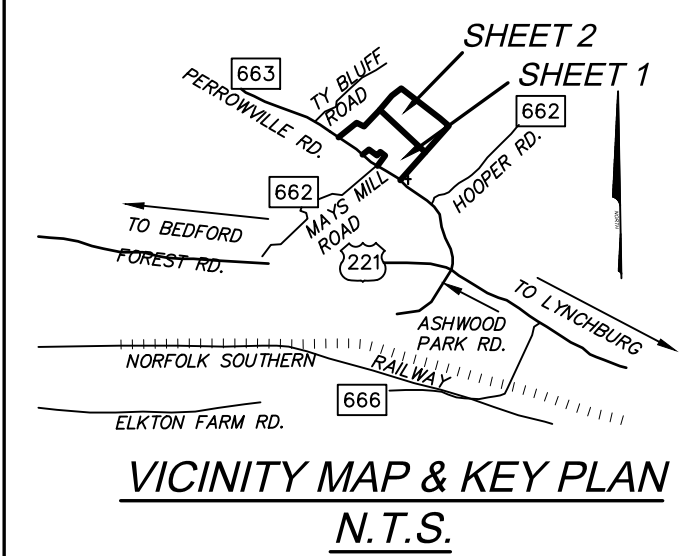

ADJACENT PROPERTY OWNERS

- RUSSELL W. & REBA M. TYREE
TM# 98-A-3B
INS. 040008849
- PETER & SUSAN H. DOBROFF
TM# 99-9-40
INS. 050011911
- STEPHEN TOLLEY CONST. CO.
TM# 99-9-39
INS. 040015314
- MICHAEL TODD & CAROL T. MIDKIFF
TM# 99-9-38
- CHRISTOPHER S. & MICHELLE MOORE
TM# 99-9-32
- PAUL DUROCHER
TM# 99-9-31
- KENNETH D. & KRISTEN N. TOMLIN
TM# 99-9-30
- RONALD W. GUTHRIE & RICCI C. ROBINSON
TM# 99-9-23
- JONATHAN K. & BONNIE C. STEELMAN
TM# 99-9-22
- MARK W. & SARAH S. LOWRY
TM# 99-9-21
- DOUGLAS A. & LAURIE L. BROWNSON
TM# 99-9-20
- DAVID WARDEN BUILDERS LLC
TM# 99-9-19
- IVY TRACE LLC
TM# 99-9-18
- EDWARD R. IVINS JR.
TM# 99-9-17
- VERNON M. & ANDERSON WILLIAM DAVIS
TM# 99-A-29
INS. 020018111
- IVY WOLF FARM LC
TM# 99-A-29A
DB. 995, PG. 743
- WILLIAM A. III & CONNIE B. HANSEN
TM# 99-6-18
INS. 990016326
- CLIFFORD & DENISA R. BOWLING
TM# 99-6-17
INS. 020014158
- STACY M. & SUSAN M. WEBB
TM# 99-6-16
INS. 020017712
- HUMBERTO III & REBECCA FAIR BAEZ
TM# 99-6-15
- DAVID R. & STEFANIE M. ANDERSON
TM# 99-5-7
DB 706, PG. 175
- JUNKO MITSUYAMA BRANDENBERGER
TM# 99-5-6
DB 04001, PG. 8043
- JEFFERSON FOREST HIGH SCHOOL
TM# 99-A-20
DB 333, PG. 683
- TRS. ST. STEPHENS PROT. EPISC.
TM# 99-A-27A
- CEMETERY
TM# 99-A-18

LEGEND

- STREAM
- ⊗ FIRE HYDRANT
- ⊙ SANITARY MANHOLE
- ⊙ WATER METER
- ⊙ WATER VALVE
- SS SANITARY SEWER LINE
- FM FORCE MAIN
- W WATERLINE

APPROVED BY SUBDIVISION AGENT DATE
REVISIONS MADE 11/21/17 ARE SHOWN IN GREEN

REVISED 05/23/2023
GRAPHIC SCALE IN FEET
1" = 200'

#	DATE	DESCRIPTION OF REVISION	SHEETS
5	11/2/2022	LOT OWNER LEGEND ADDED	C 0.1
4	11/21/2017	REVISED PER COUNTY COMMENTS	C 0.1
3	11/02/2017	SEC 20 REVISED	C 0.2
2	7/15/2008	SEC 12 & 13 REVISED	C 0.1
1	7/26/2007	REVISED PER COUNTY COMMENTS	ALL

HURT & PROFFITT
INSPIRED / RESPONSIVE / TRUSTED

434.847.7796
2524 LANGHORNE ROAD
LYNCHBURG, VA 24501

HANDP.COM
ENVIRONMENTAL
ENGINEERING • SURVEYING • LAND DEVELOPMENT • INSPECTION • CULTURAL RESOURCES

MASTER PLAN
FOR
FARMINGTON AT FOREST - PHASE 2
BEDFORD COUNTY, VIRGINIA

PROJECT NO. 20222013
LAT. _____
LONG. _____
DATE: 11/09/2022
DRAWN BY: DBM
CHECKED BY: DBA

REVIEW SET

HURT & PROFFITT

SHEET NO. C100 REV. _____

THIS SHEET IS INTENDED TO BE REPRODUCED AT XCOPY. REPRODUCTION OF THIS SHEET AT A DIFFERENT SIZE THAN INTENDED SHALL VOID THE SCALE SHOWN ON THE SHEET.